
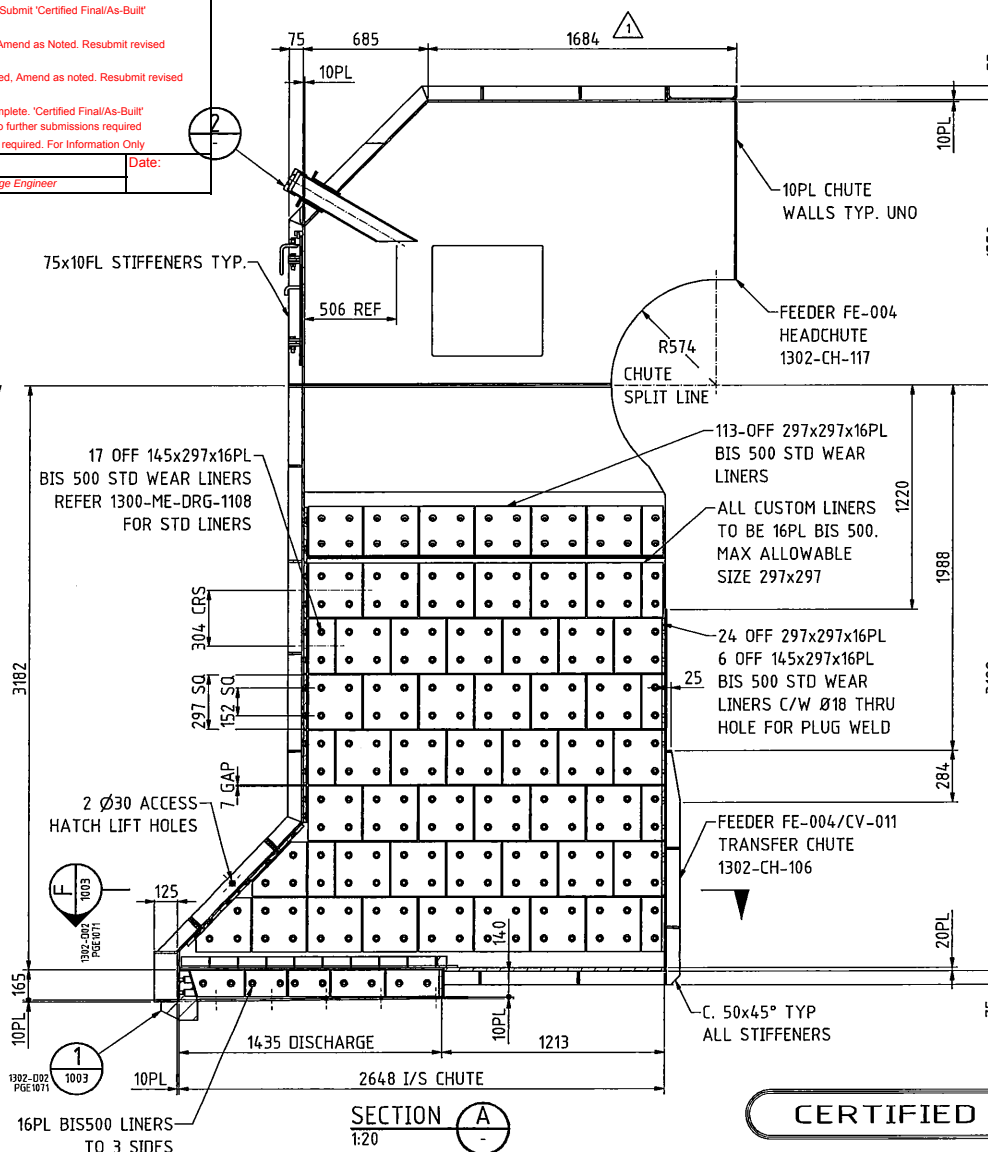
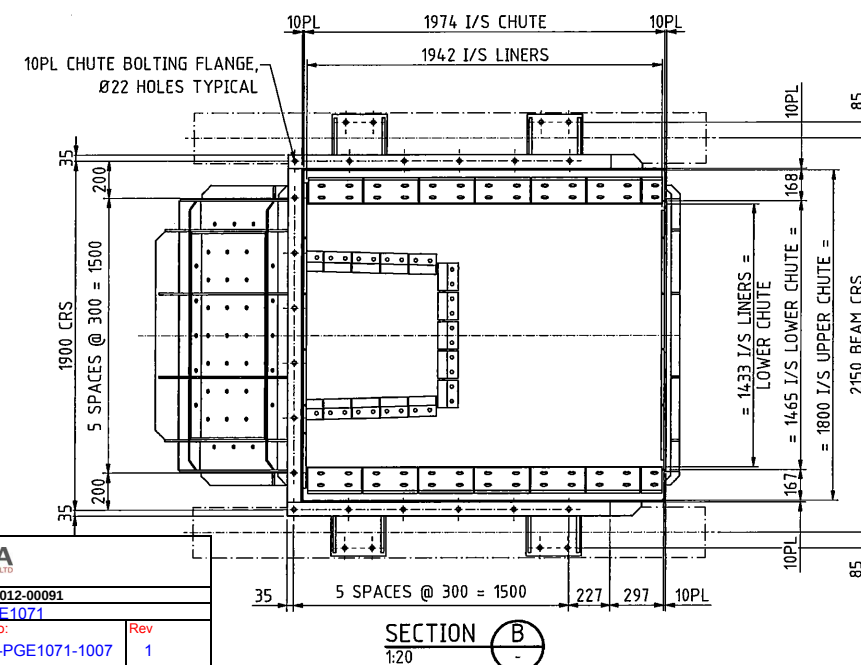
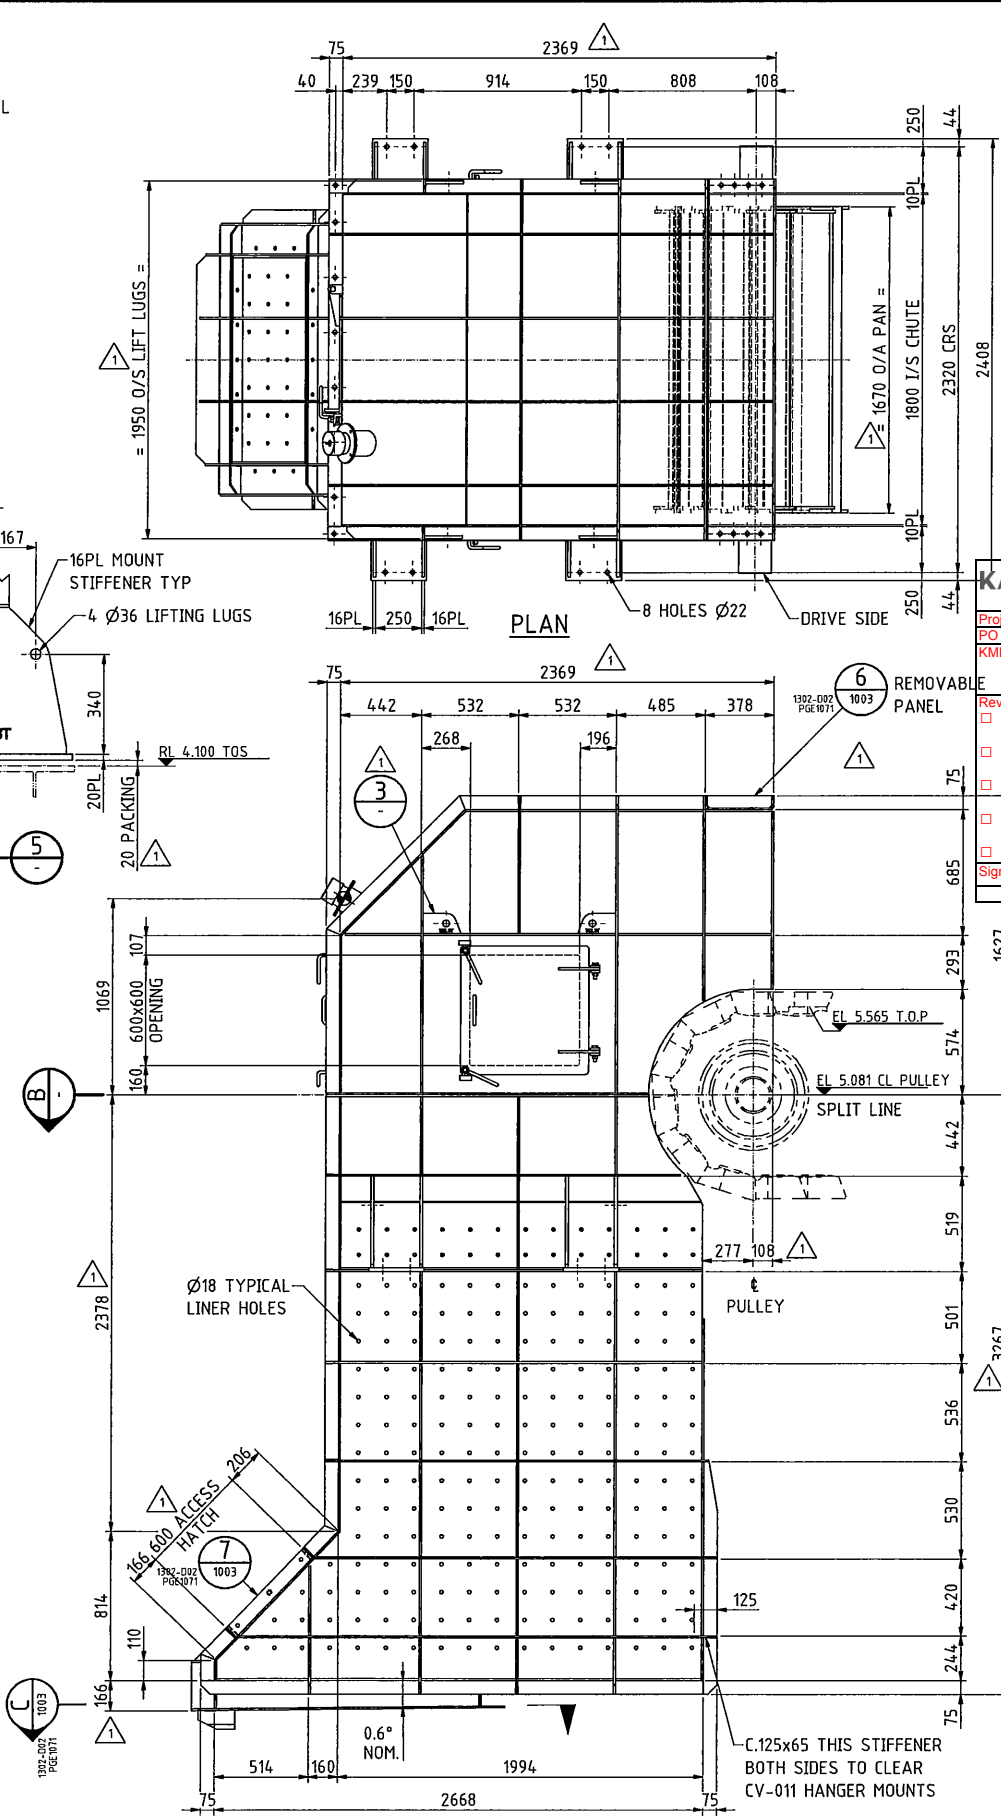
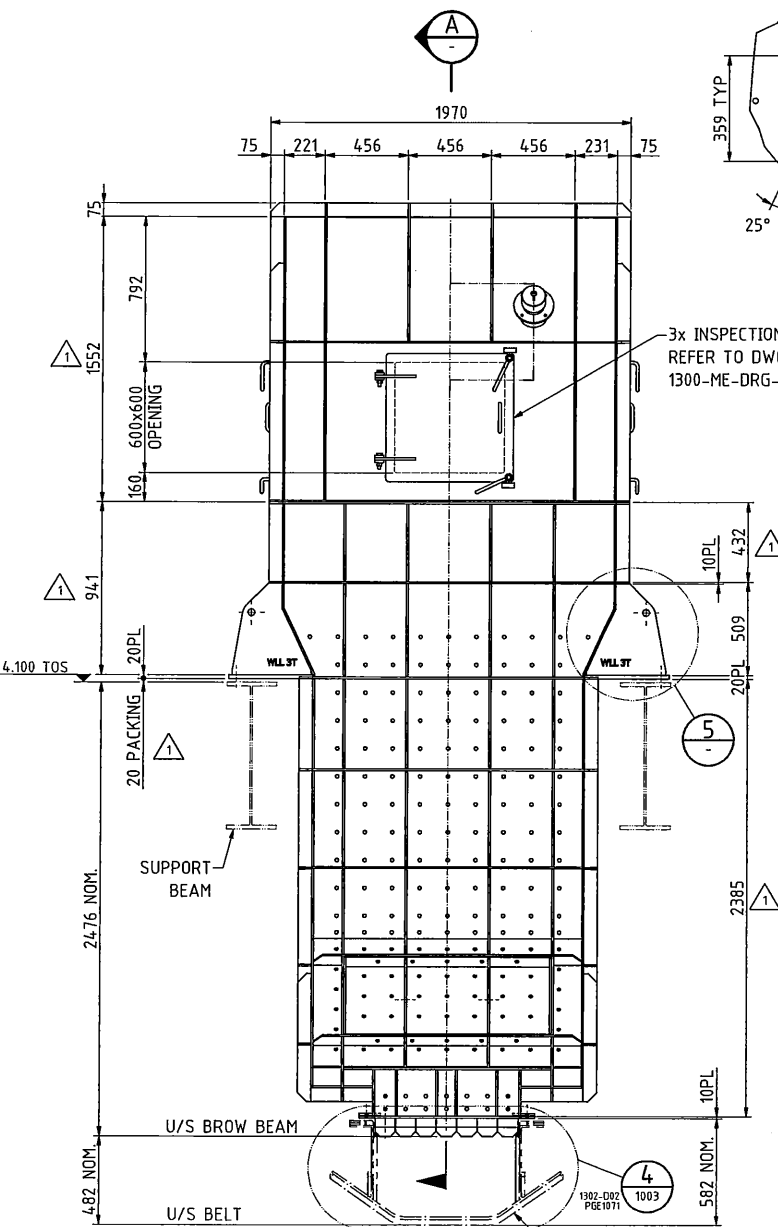 




MASS - EMPTY	
LOWER	5180 kg
UPPER	1307 kg

THIS DRAWING AND ITS CONTENTS ARE CONFIDENTIAL, ARE SUBJECT TO RETURN ON DEMAND AND MAY NOT BE COPIED OR DISCLOSED TO ANY THIRD PARTY OR USED DIRECTLY OR IN-DIRECTLY FOR ANY OTHER PURPOSE THAN AS EXPRESSLY DETERMINED IN WRITING BY RCR TOMLINSON.	7																		21 WILSON ROAD PO BOX 545 BUNBURY WA 6231	PH: +61 8 9726 4555 FAX: +61 8 9725 6114 EMAIL: buneng@rcrtom.com.au www.rcrtom.com.au
	6																			
	5																			
	4	1302-FE-004/CV-011 TRANSFER CHUTE CHU-106 BOLT LOADS & DETAILS	1302-D02-PGE1071-1003	3	AS BUILT	JR	CJ	05.10.11	DESIGNED	RCR	DATE	TITLE KARARA IRON ORE - STOCKPILE RECLAIM 1302-FE-004/CV-011 TRANSFER CH-117/CH-106 GENERAL ARRANGEMENT								
	3	MECHANICAL STANDARD LINER PLATE DETAILS	1300-ME-DRG-1108	2	APPROVED FOR CONSTRUCTION	JR	CJ	18.03.11	DRAWN	JR	21.10.10									
	2	MECHANICAL STANDARD INSPECTION NON IMPACT DOOR DETAILS	1300-ME-DRG-1106	1	REVISED TO CLIENT MARKUPS	JR	CJ	18.01.11	CHECKED	CJ	21.10.10									
1	MECHANICAL STANDARD BLOCKED CHUTE TILT SWITCH DETAILS	1300-ME-DRG-1109	0	ISSUED FOR CONSTRUCTION	JR	CJ	22.10.10	APPROVED	<i>[Signature]</i>	<i>[Signature]</i>										
THIS IS AN INVENTOR CREATED DRAWING	REF. No	TITLE	ORG. No	REV	DESCRIPTION	BY	CKD	APD	DATE	CLEINT	KARARA MINING	SCALE	1:20	SHEET SIZE	A1	DRG No	1302-D01-PGE1071-1007	REV	3	

ORIGINAL